STOREFRONT ELEVATION

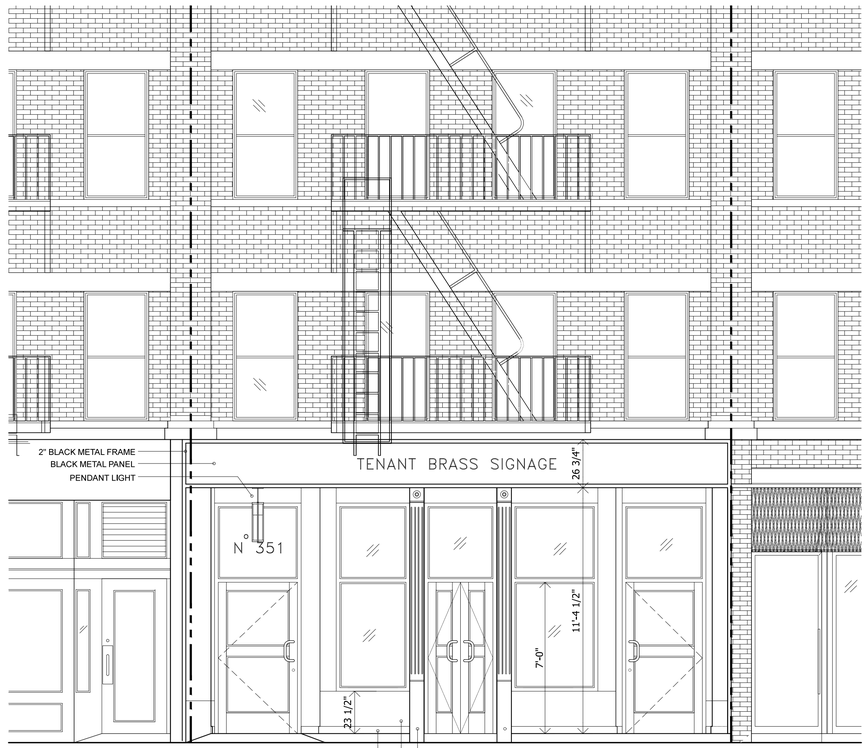

STOREFRONT ELEVATION

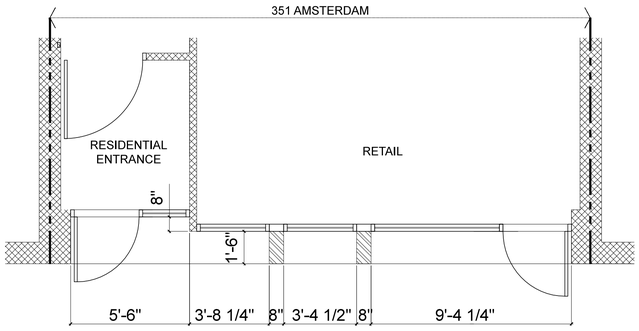

STOREFRONT PLAN

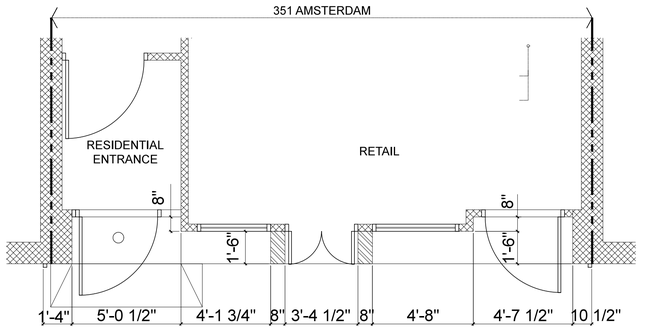

STOREFRONT PLAN

LPC APPROVED CONDITION

NOT TO SCALE

AS-BUILT CONDITION

NOT TO SCALE

GEC DESIGN GROUP LTD.
97 SWEET BRIAR ROAD,
STAMFORD CT, 06905
PHONE: 203-329-9262
EMAIL:gary@gecdesigngroup.com

CWS Architecture PC
383 Carlton Ave. #10E
Brooklyn, NY 11238
212-203-8037
www.cwsarchitecture.com

PROJECT:
SACKMAN ENTERPRISES
RENOVATIONS TO: 351 AMSTERDAM AVENUE
Cellar and First Floor Renovations & Addition
New York City, New York 10023

ISSUE	REV	ISSUE FOR	DATE
1.		CLIENT REVIEW AND PERMITTING	06/12/16

© COPYRIGHT 2016 This drawing is the property of the GEC DESIGN GROUP Ltd. It is subject to copyright laws and shall not be used or copied without express written permission.

SEAL

SCALE:	DATE:	PROJECT NO.:
AS NOTED		140503
DRAWN BY:	CHECKED BY:	APPROVED BY:

DRAWING TITLE:
PROPOSED STOREFRONT

DRAWING NO:
A-001.00